


BY: waeschel -

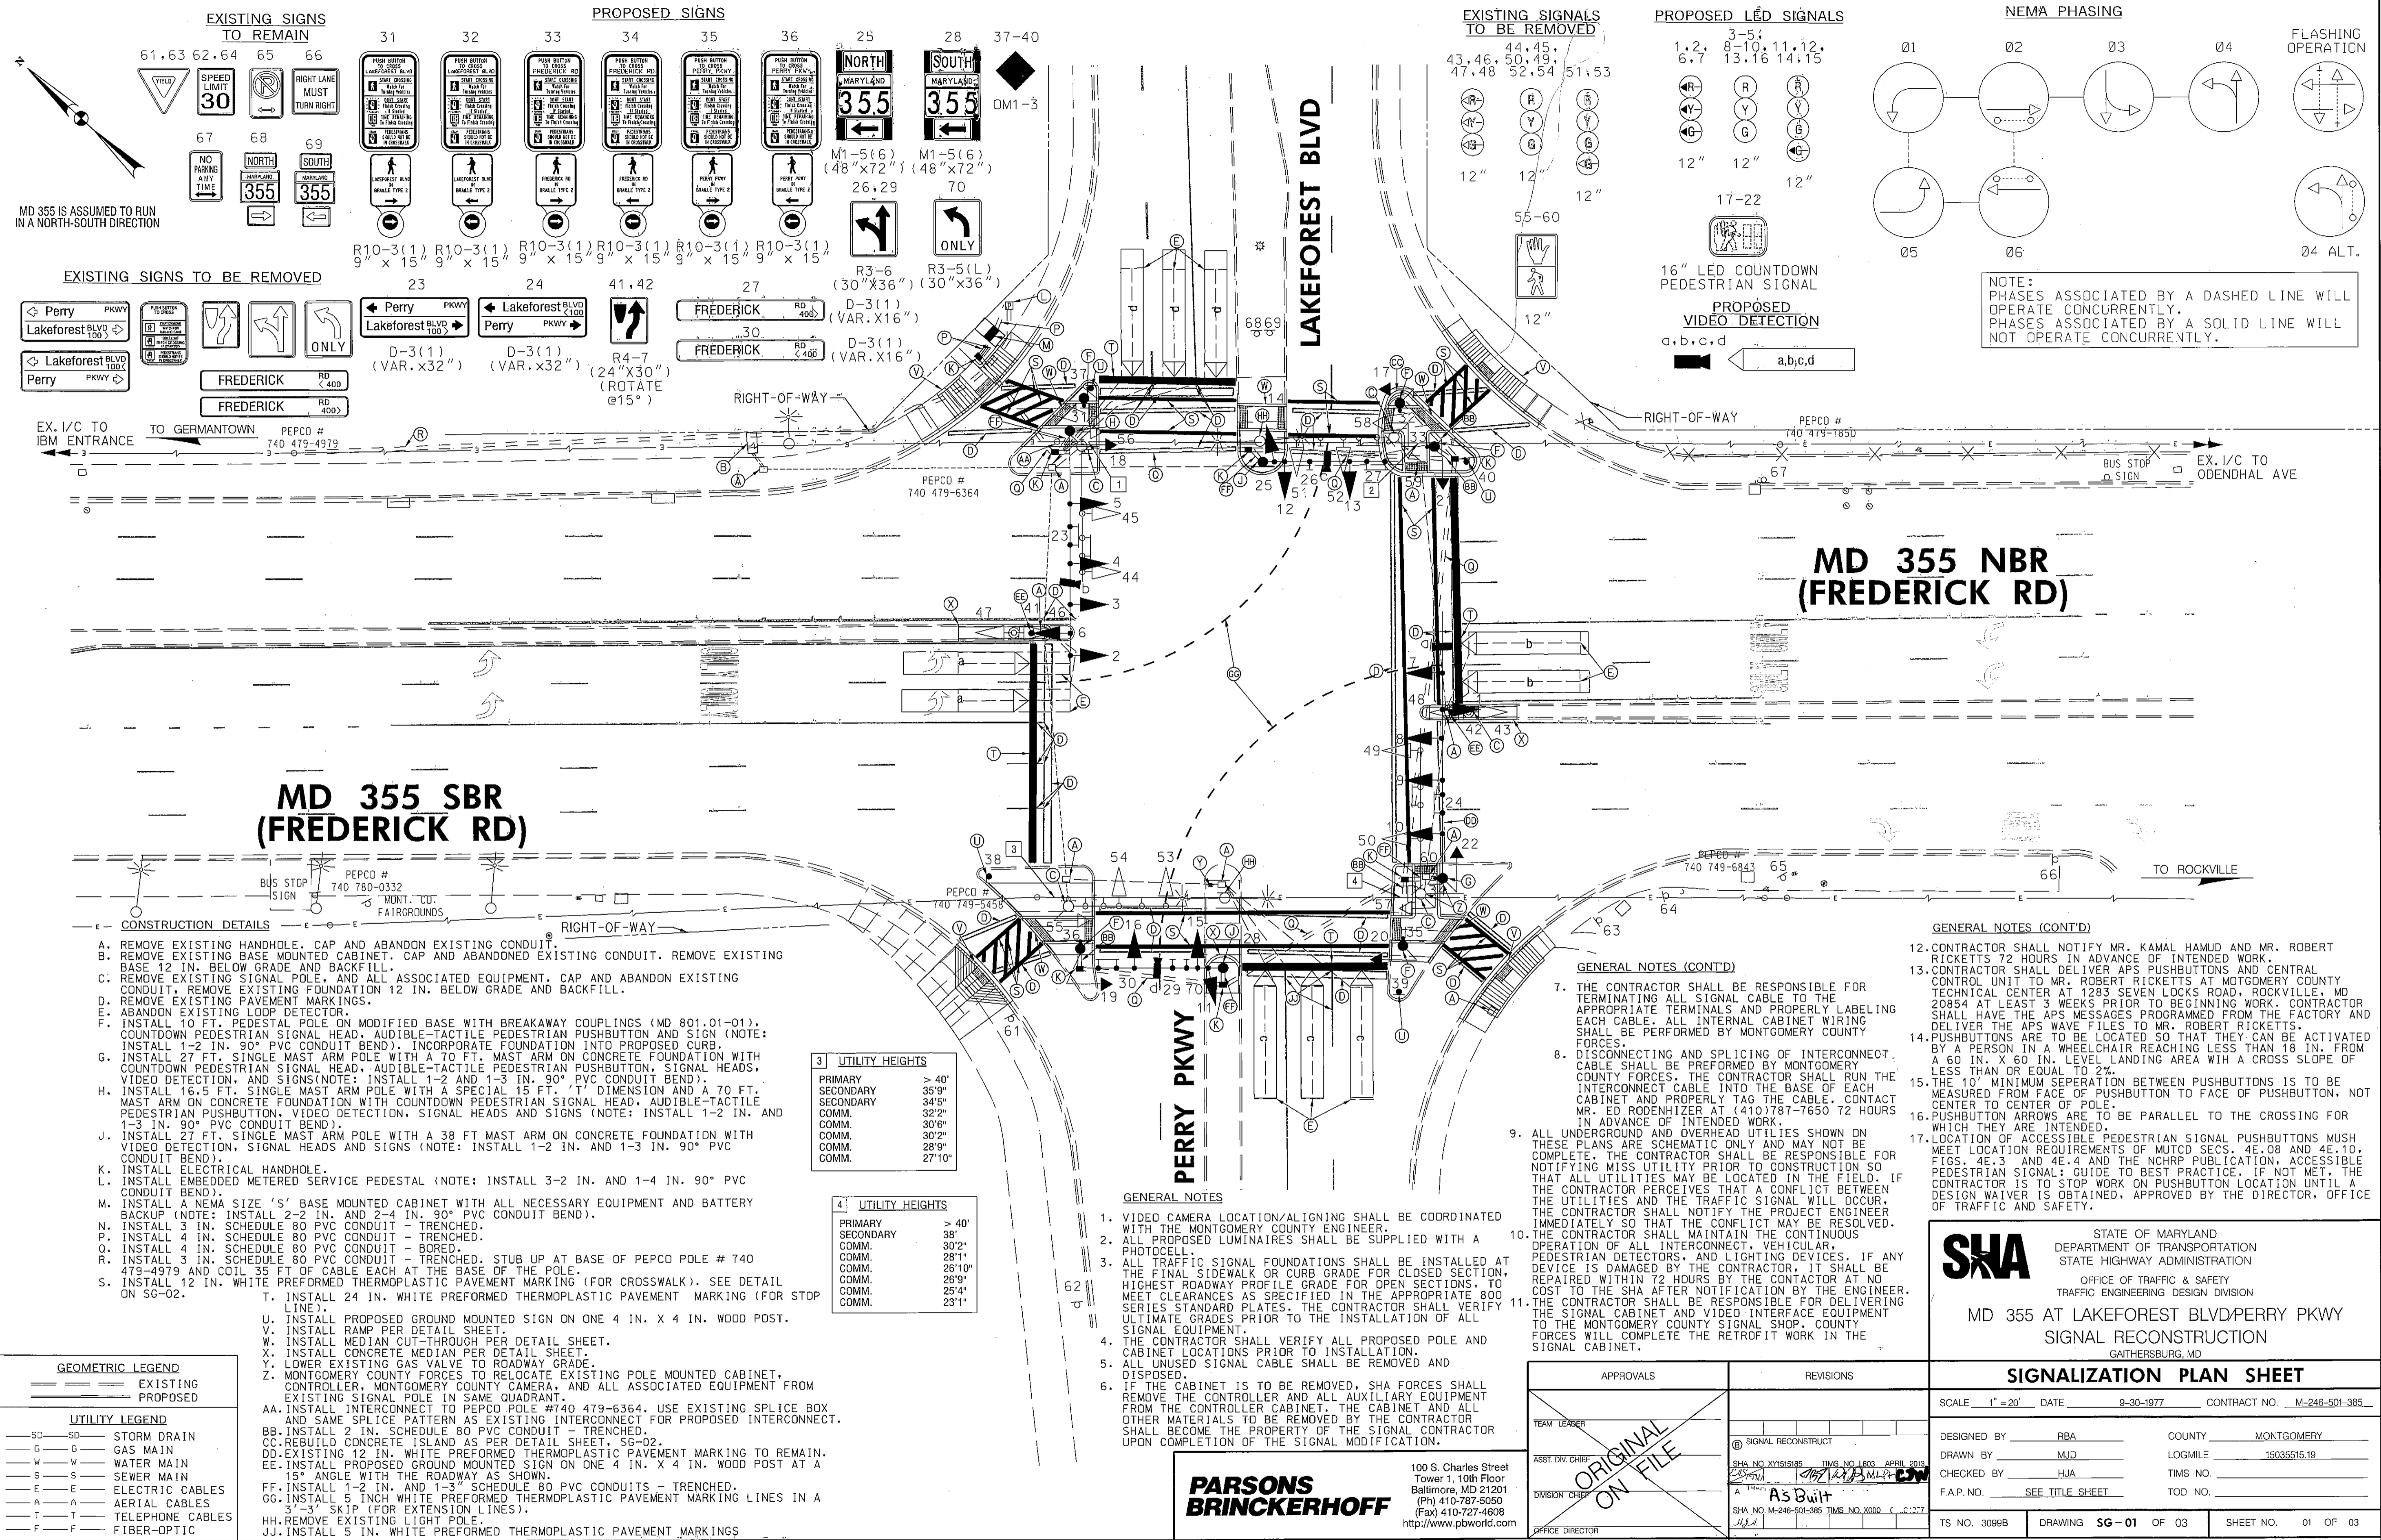

**PARSONS  
BRINCKERHOFF**

100 S. Charles Street  
Tower 1, 10th Floor  
Baltimore, MD 21201  
(Ph) 410-787-5050  
(Fax) 410-727-4608  
<http://www.pbworld.com>

APPROVALS		REVISIONS		<h2 style="text-align: center;">SIGNALIZATION PLAN SHEET</h2>			
<div style="position: relative; height: 100px;"> <div style="position: absolute; top: 50%; left: 50%; transform: translate(-50%, -50%) rotate(-45deg); font-size: 40px; opacity: 0.5;">ORIGINAL ON FILE</div> </div>		<div style="border: 1px solid black; padding: 5px;"> <p>② SIGNAL RECONSTRUCT</p> <p>SHA NO. X1918186 TIMS NO. 4293 APRIL 2019</p> <p><i>AS BUILT</i></p> <p>SHA NO. M-246-501-385 TIMS NO. X090 C. 1277</p> </div>		SCALE 1" = 20'    DATE 9-30-1977    CONTRACT NO. M-246-501-385			
				DESIGNED BY <u>RBA</u> COUNTY <u>MONTGOMERY</u>			
				DRAWN BY <u>MJD</u> LOGMILE <u>15035515.19</u>			
				CHECKED BY <u>HJA</u> TIMS NO. _____			
DIVISION CHIEF _____		F.A.P. NO. <u>SEE TITLE SHEET</u> TOD NO. _____		TS NO. 3099B    DRAWING <b>SG-01</b> OF 03    SHEET NO. 01 OF 03			
OFFICE DIRECTOR _____							

PLOTTED: Monday, April 29, 2013 AT 11:01 AM  
FILE: T:\173124A-TrafficDesignServices\TRF\112\Plans\pSG\_P001-L713\_LakeForest.dgn